




1 EXTERIOR ELEVATION: WEST  
 1/16"=1'-0"

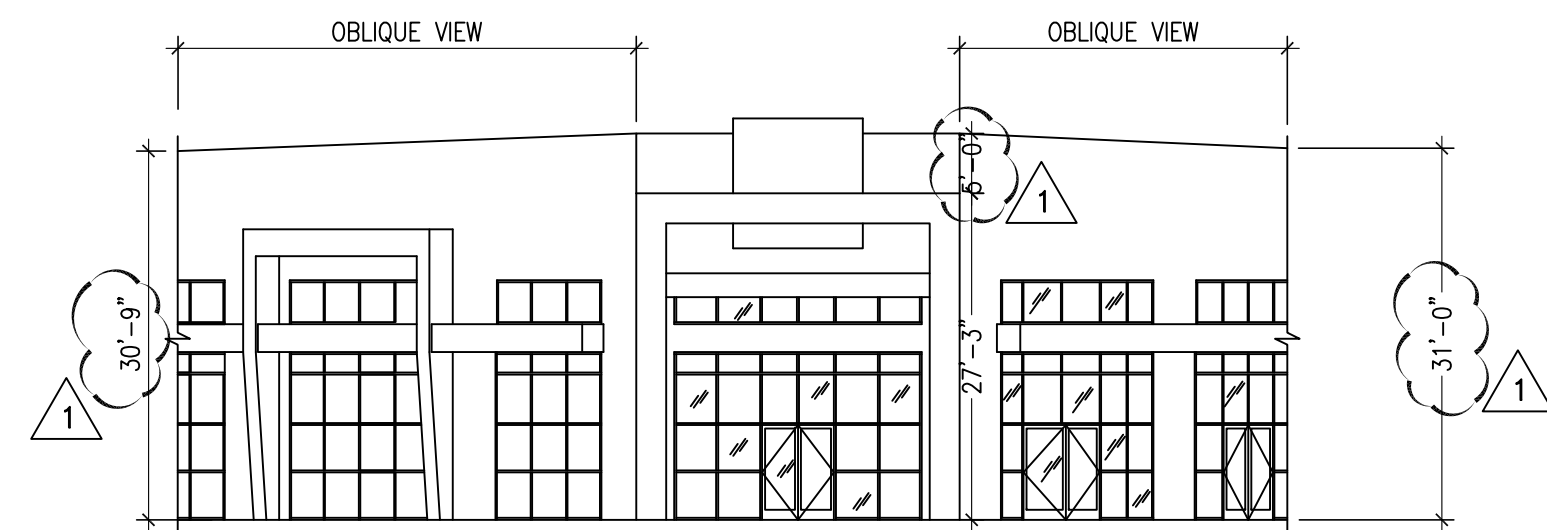


3 EXTERIOR ELEVATION: FRONT ENTRY  
 1/16"=1'-0"

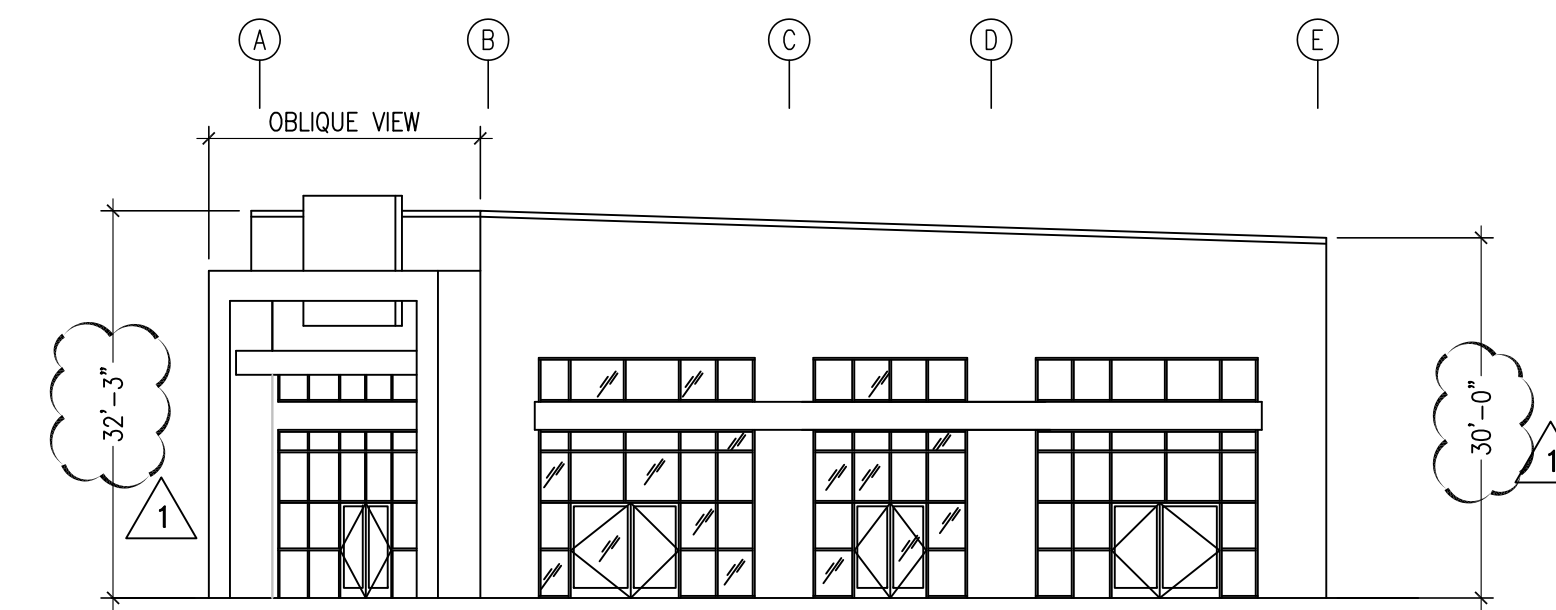

2 EXTERIOR ELEVATION: NORTH  
 1/16"=1'-0"

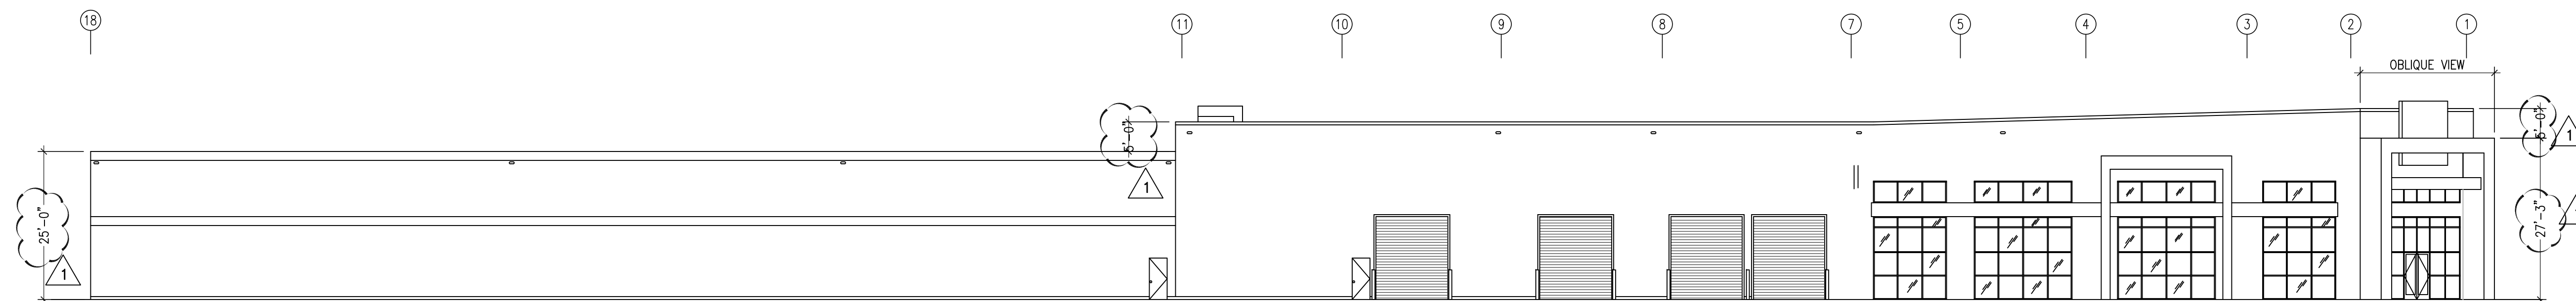


4 EXTERIOR ELEVATION: EAST  
 1/16"=1'-0"

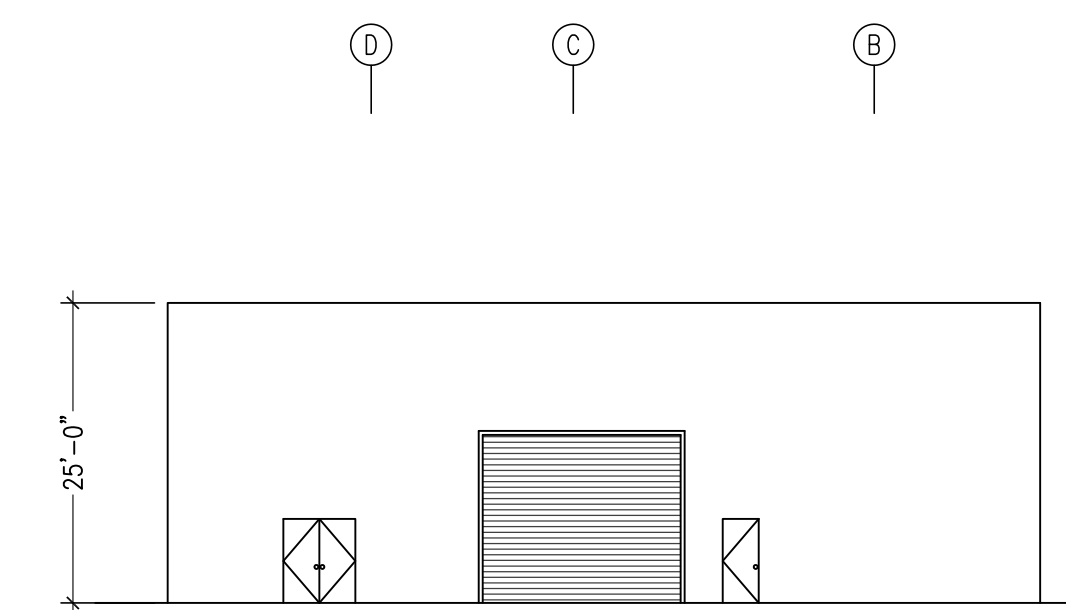

5 EXTERIOR ELEVATION: SOUTH  
 1/16"=1'-0"

No.	Description	Date	By
	CUP SUBMITTAL SET	08/15/17	CT
Δ	PLAN CHECK	09/22/17	CT

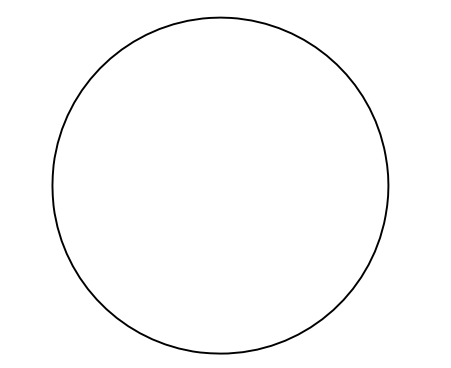

**EXISTING  
 ELEVATION  
 PLAN**

Project number	17-4520-16
Date	
Drawn by	LF
Checked by	LF













**EXTERIOR** | HORIZONTAL MONUMENT APPROX 11'-2"H X 6'-0"W (57SQFT SIGNAGE TOTAL)





**EXTERIOR | VIEW 1 | CAR SALES ILLUMINATED CABINET SIGN WITH PUSH-THROUGH LETTERING 4'-0"H X 20'-0"W**





**EXTERIOR | VIEW 2 |** CAR SALES ILLUMINATED CABINET SIGN WITH PUSH-THROUGH LETTERING 4'-0"H X 20'-0"W (80SQFT) | CUSTOM RAC/TR ILLUMINATED CO-LOCATED PYLON SIGN WITH PUSH-THROUGH LETTERING 6'-8" X 10'-7" (70.5SQFT)