

ALL DRAWINGS ARE FOR INFORMATIONAL USE ONLY. NOT FOR CONSTRUCTION PURPOSES.

ALUM.	ALUMINIUM
A.A.R.	COLD AIR RETURN
CONC.	CONCRETE
C.R.	CEILING REGISTER
D	DRYER
DN	DOWN
FLRG.	FLOORING
F.R.	FLOOR REGISTER
F.P.	FIREPLACE
REF.	REFRIGERATOR
S.G.	SECURITY GATE
T	THERMOSTAT
U.O.N.	UNLESS OTHERWISE NOTED
VAN.	VANITY
W	WASHER
W.C.	TOILET
WH	WATER HEATER

Architectural Floor Plan Details:

- Overall Dimensions:** 36'-7" (Total Width) x 31'-9" (Total Depth).
- Rooms and Features:**
 - Living Room:** CH: 7'-11" FLRG: WOOD SIZE: 212 SF. Includes F.P. (Fireplace).
 - Dining Room:** CH: 7'-11" FLRG: WOOD SIZE: 104 SF. Includes F.R. (Fridge).
 - Kitchen:** CH: 7'-11" FLRG: VINYL SIZE: 132 SF. Includes SINK, GAS RANGE, and REF. (Refrigerator).
 - Family Room:** CH: 8'-9" FLRG: WOOD SIZE: 225 SF. Includes SLOPED CEILING and BAY WINDOW.
 - Bedroom 1:** CH: 8'-3" FLRG: VINYL SIZE: 160 SF.
 - Bedroom 2:** CH: 8'-3" FLRG: VINYL SIZE: 160 SF.
 - Bath 1:** CH: 7'-3" FLRG: VINYL SIZE: 42 SF.
 - Bath 2:** CH: 7'-1" FLRG: VINYL SIZE: 49 SF.
 - Garage:** CH: 8'-9" FLRG: SLAB ON GRADE SIZE: 238 SF.
 - Front Porch:** 34"x54".
 - Back Porch:** 34"x54".
 - Greenhouse Box Window:** 34"x35".
 - Entry Door:** 34"x54".
 - Stairs:** 15 STEPS 7" RISE 10" RUN. UP and DN (Down) directions.
 - Windows:** 48"x36" FIXED PICTURE, 48"x54" FIXED PICTURE, 48"x36" FIXED PICTURE.
 - Doors:** ALUM. SLIDING GLASS DOOR SINGLE GLAZED 72"x80".
 - Other Features:** CLOSET 1, CLOSET 2, CLOSET 3, CLOSET 4, CLOSET 99, CLOSET 100.

PLAN SYMBOL LEGEND

 EXISTING WALLS

2101 WEST AVENUE 136TH
SAN LEANDRO, CA 94577

[illegible]

AS-BUILT FLOOR PLANS

AB
0.1

C.A.R.	COLD AIR RETURN
CONC.	CONCRETE
C.R.	CEILING REGISTER
D	DRYER
DN	DOWN
FLRG.	FLOORING
F.R.	FLOOR REGISTER
F.P.	FIREPLACE
REF.	REFRIGERATOR
S.G.	SECURITY GATE
T	THERMOSTAT
U.O.N.	UNLESS OTHERWISE NOTED
VAN.	VANITY
W	WASHER
W.C.	TOILET
WH	WATER HEATER


PLN18-0030
EXHIBIT C
August 2, 2018

 EXISTING WALL TO REMAIN


AS-BUILT
FLOOR
PLANS

SCALE : $\frac{1}{4}" = 1'-0"$
SHEET :


AB 0.2

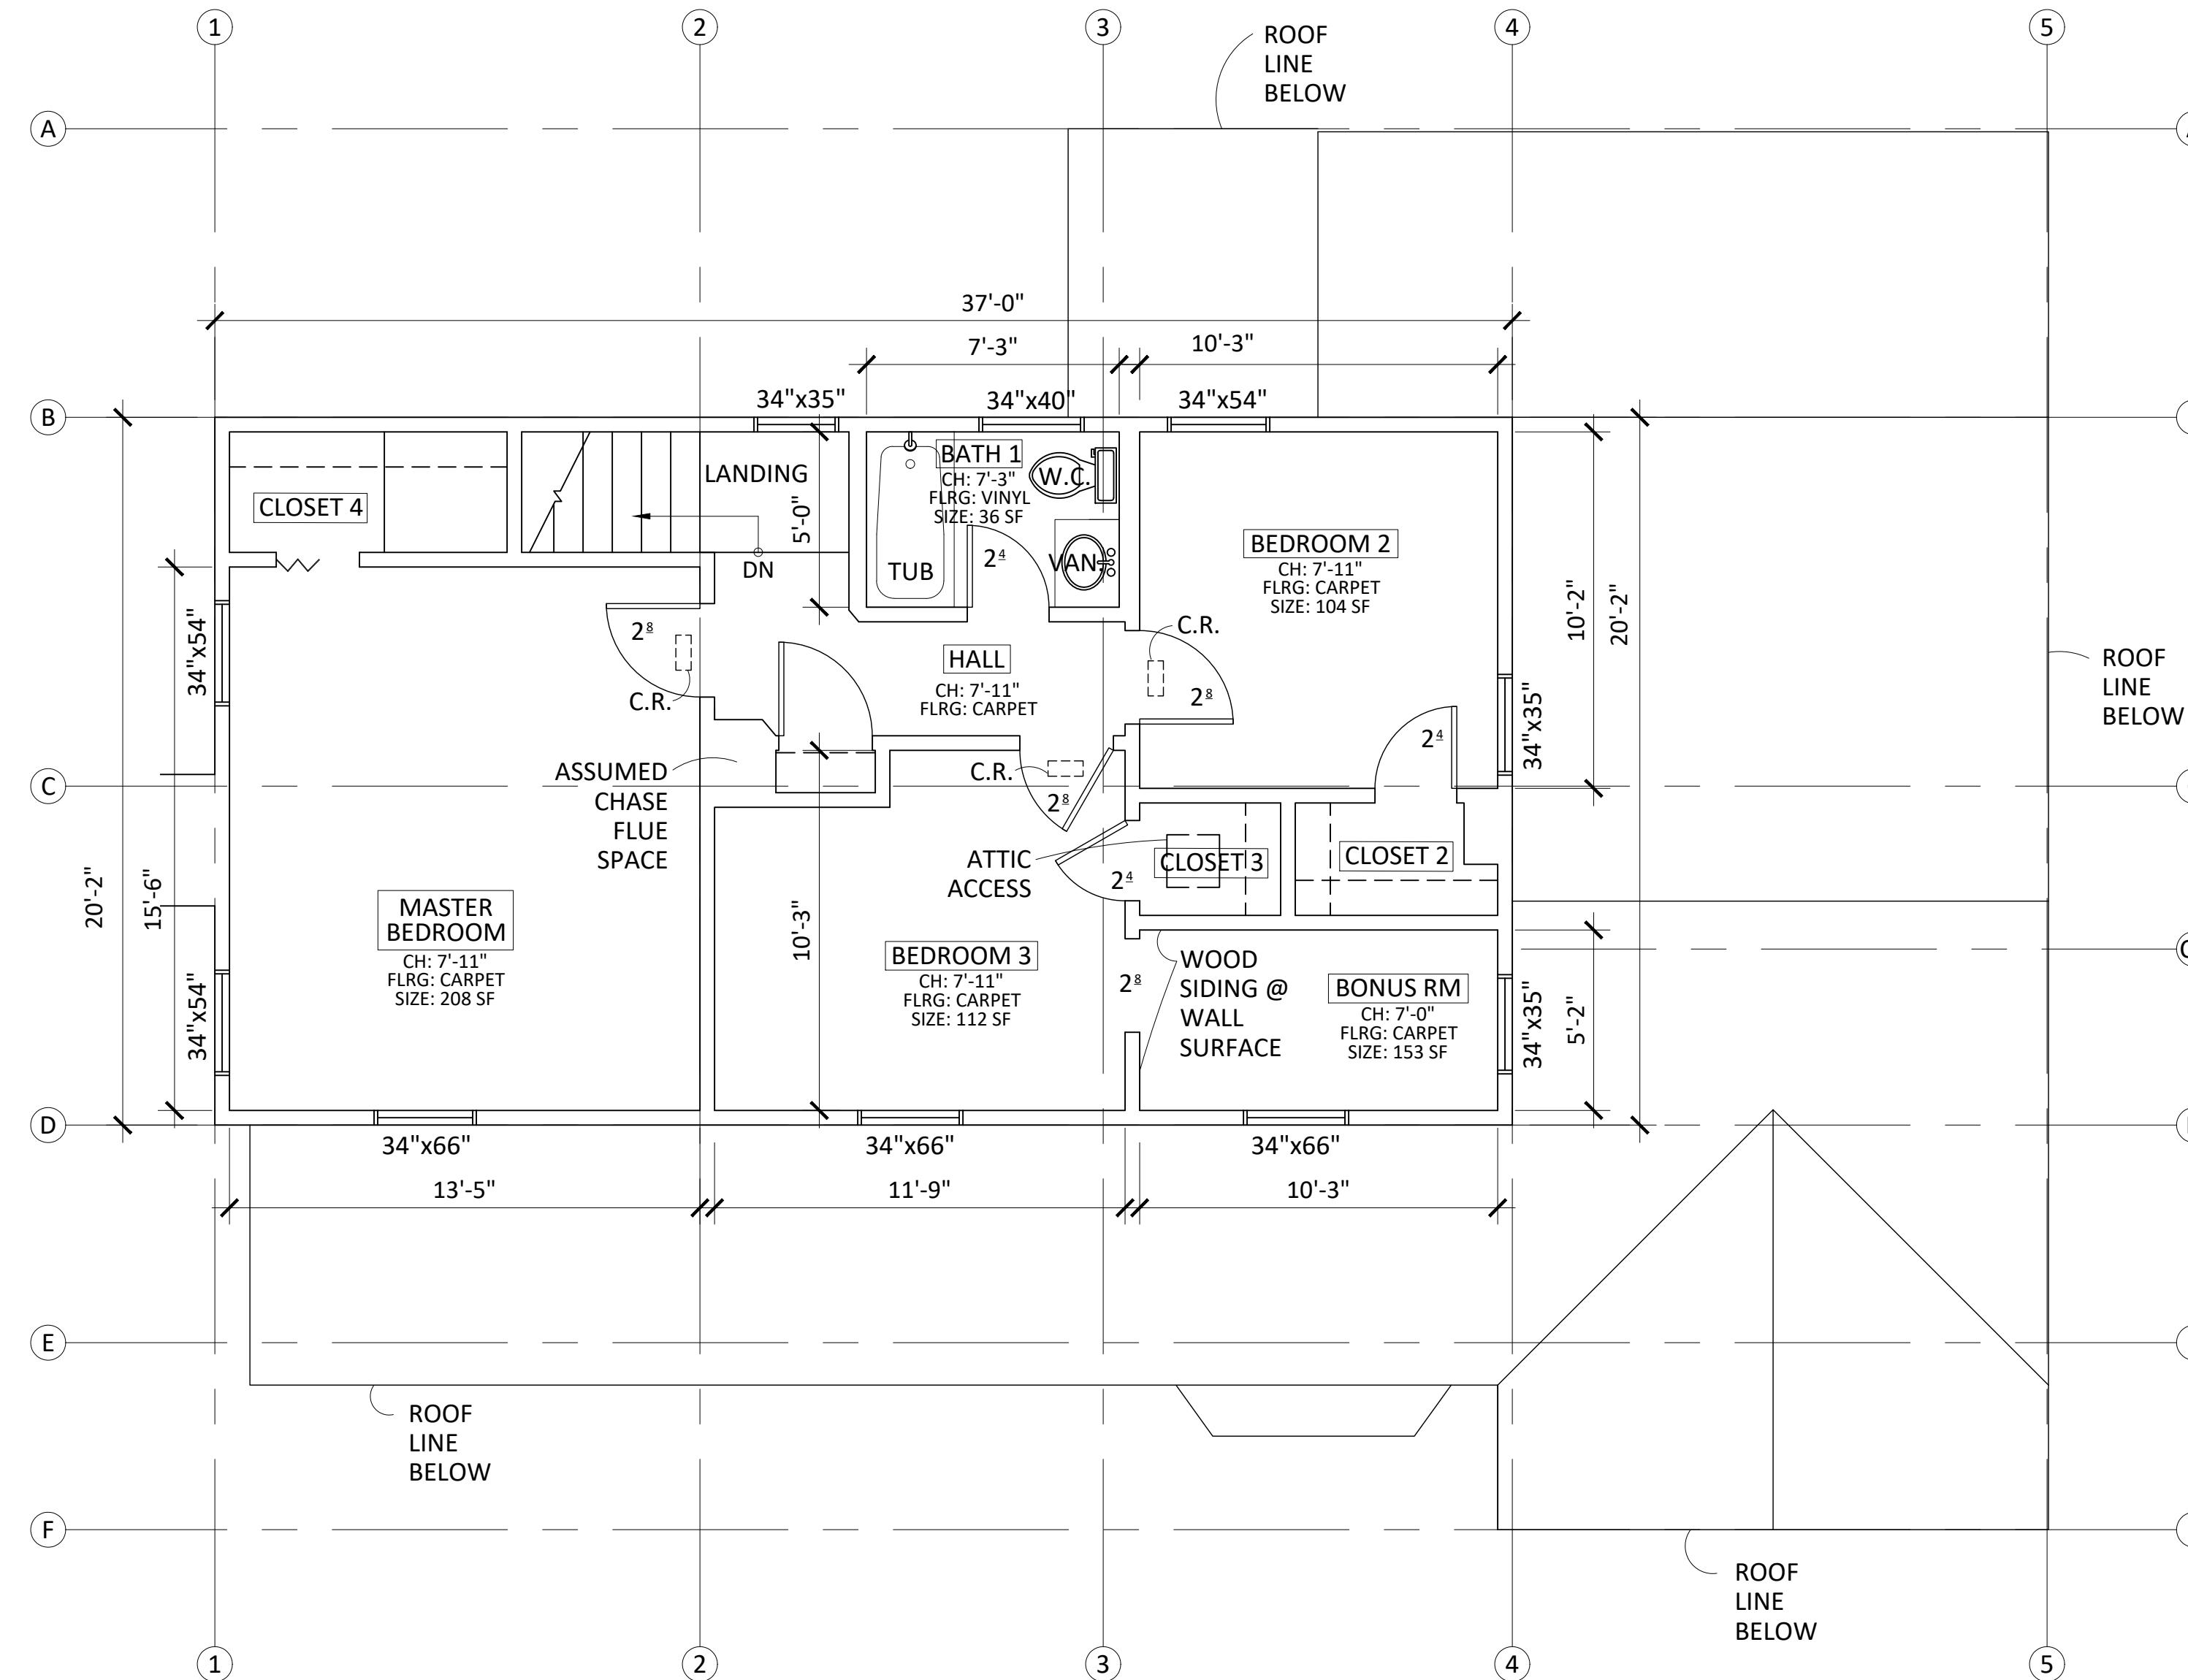

AS-BUILT SECOND FLOOR PLAN
SCALE: $\frac{1}{4}" = 1'-0"$

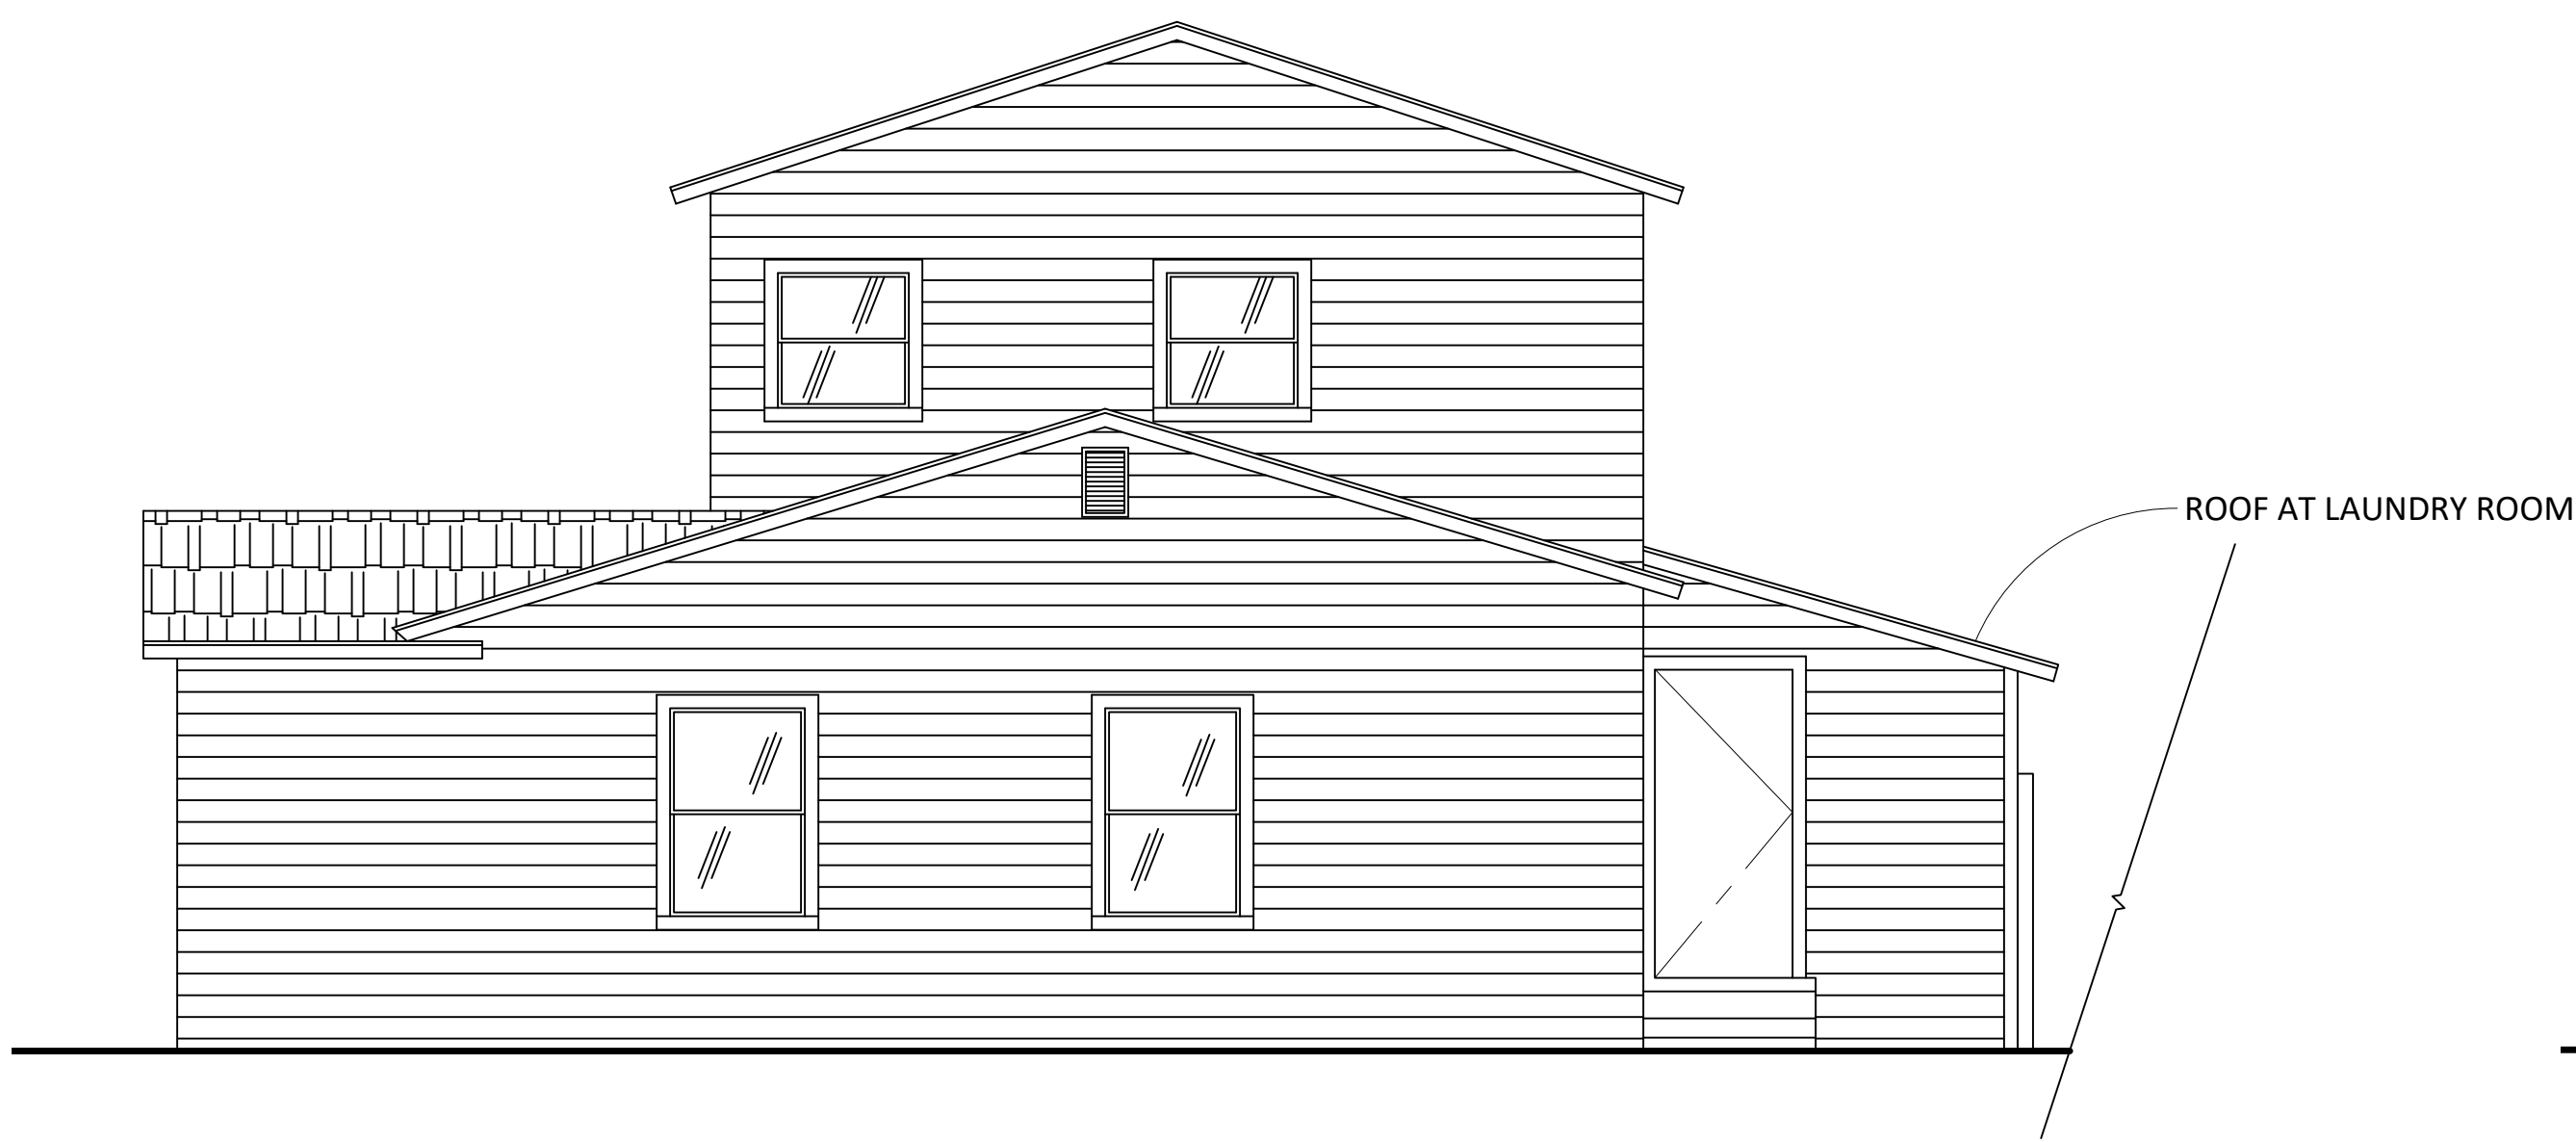

SIDE/ EAST ELEVATION

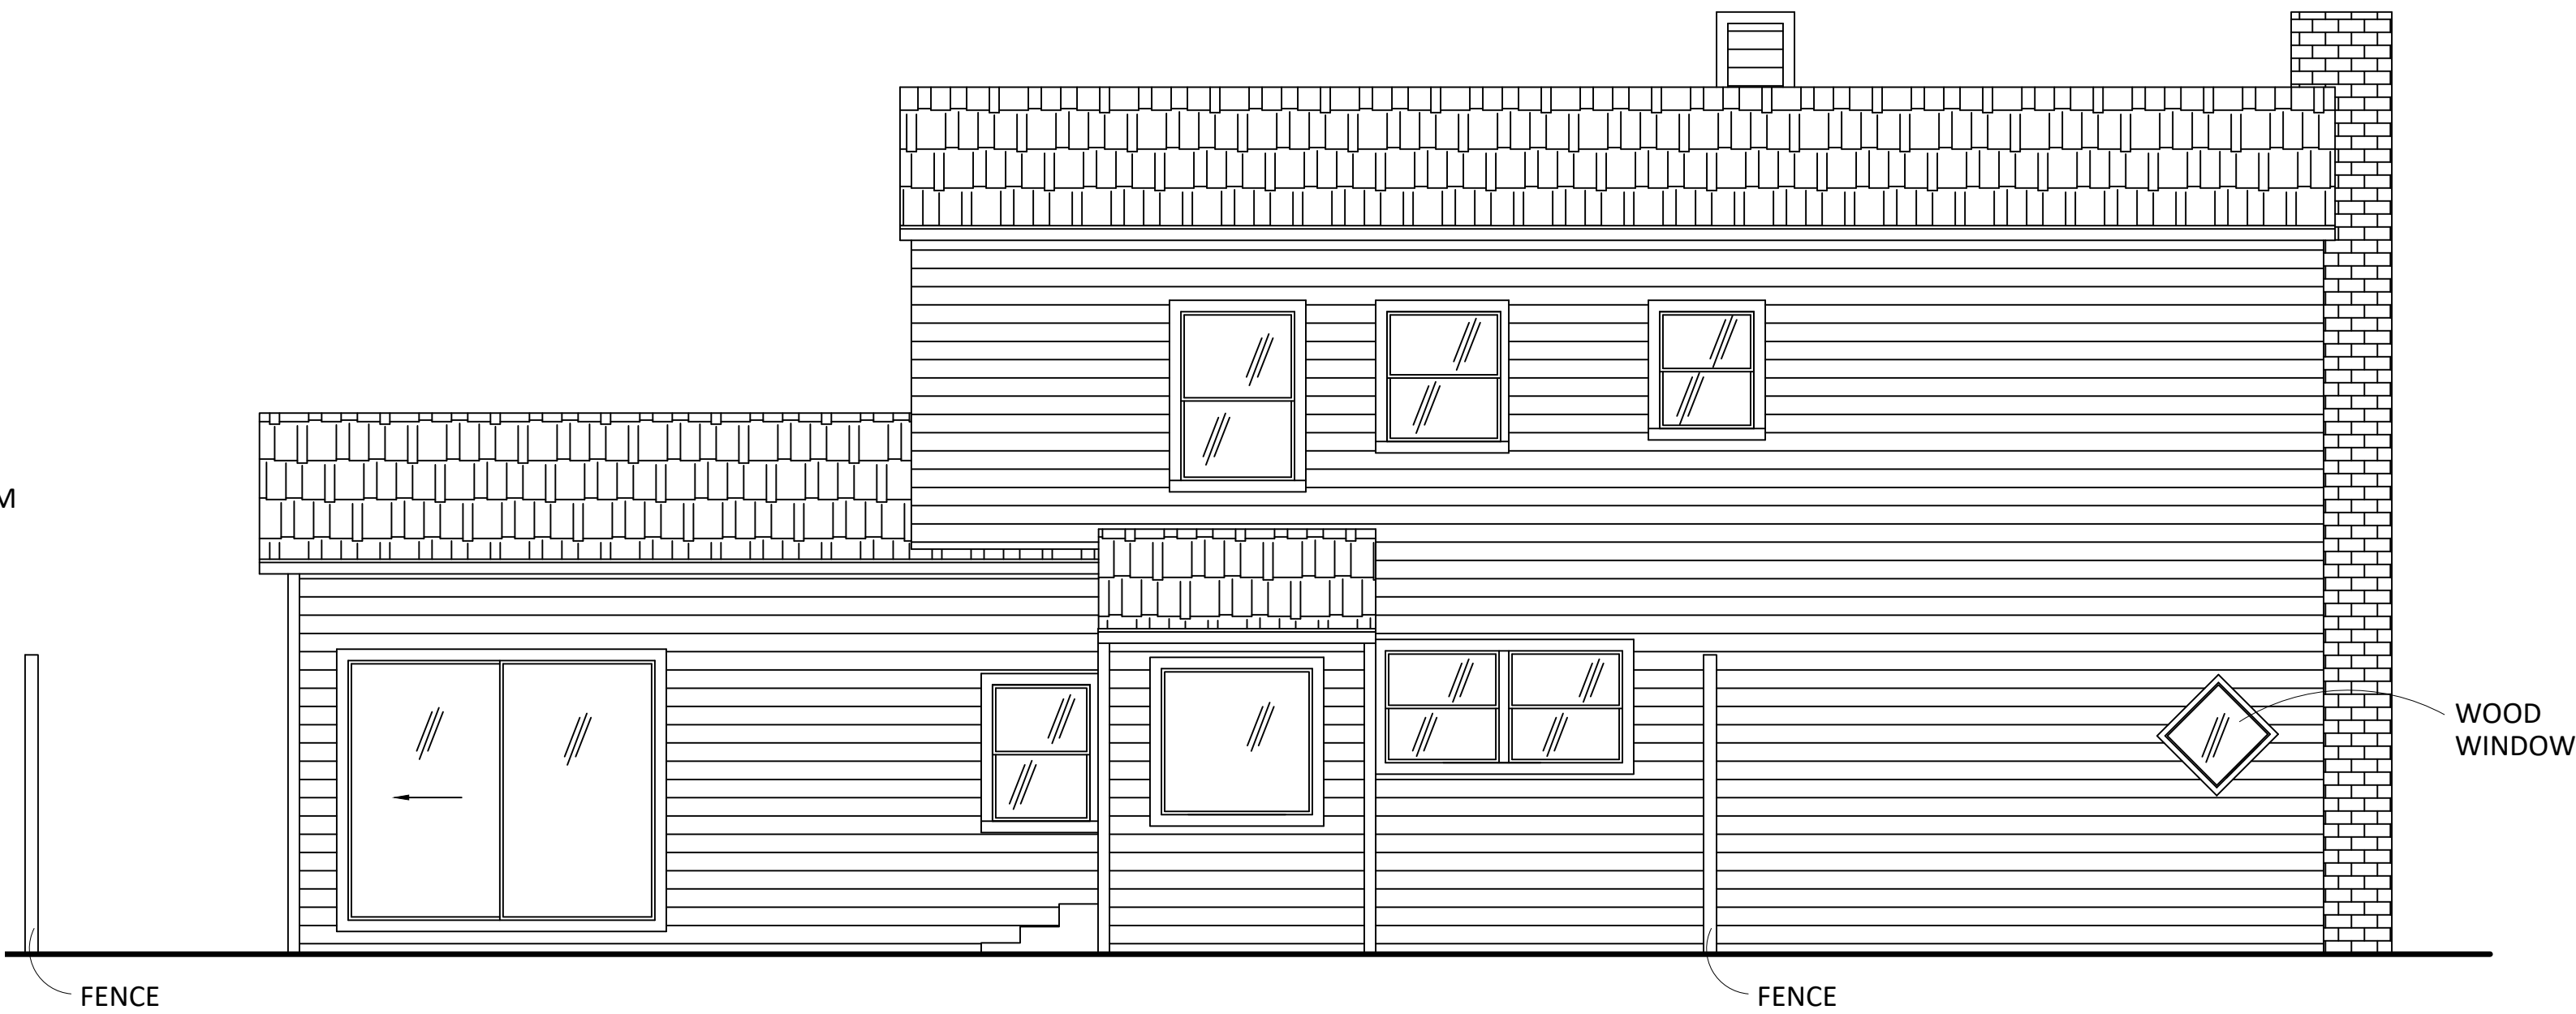

REAR/ NORTH ELEVATION


AS-BUILT ELEVATIONS

2


SCALE: 1/4" = 1'-0"

PLN18-0030
EXHIBIT D
August 2, 2018

NOTE:
SEE FLOOR PLAN SHEETS FOR
ABBREVIATIONS AND GENERAL NOTES.

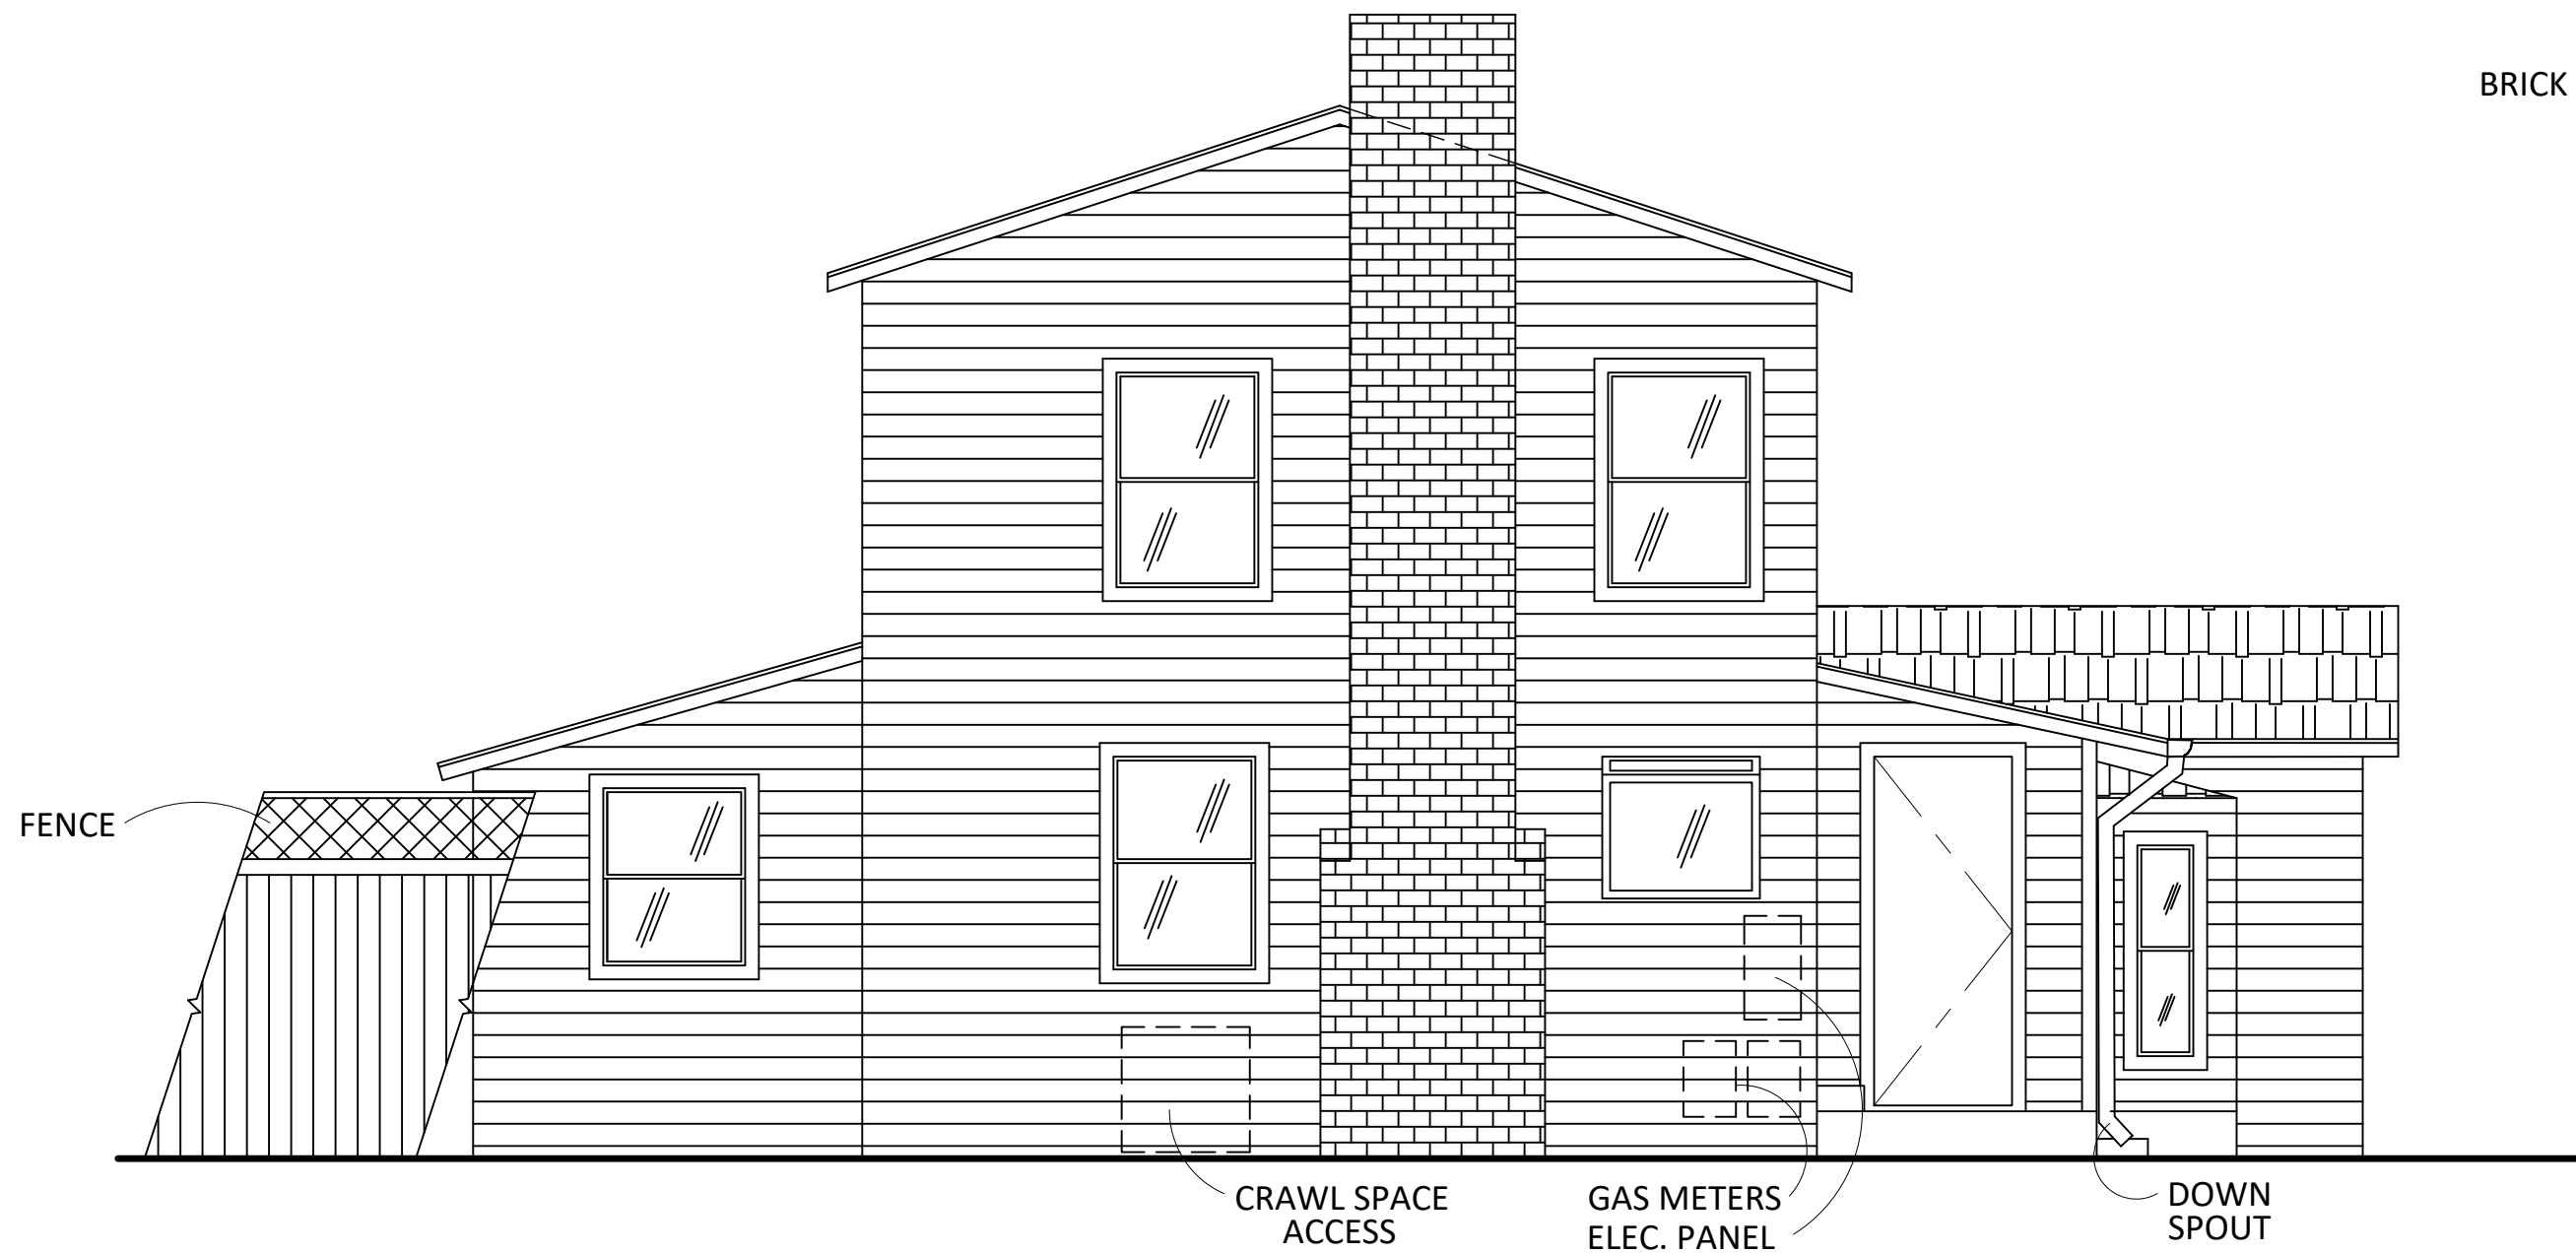

SIDE/ WEST ELEVATION

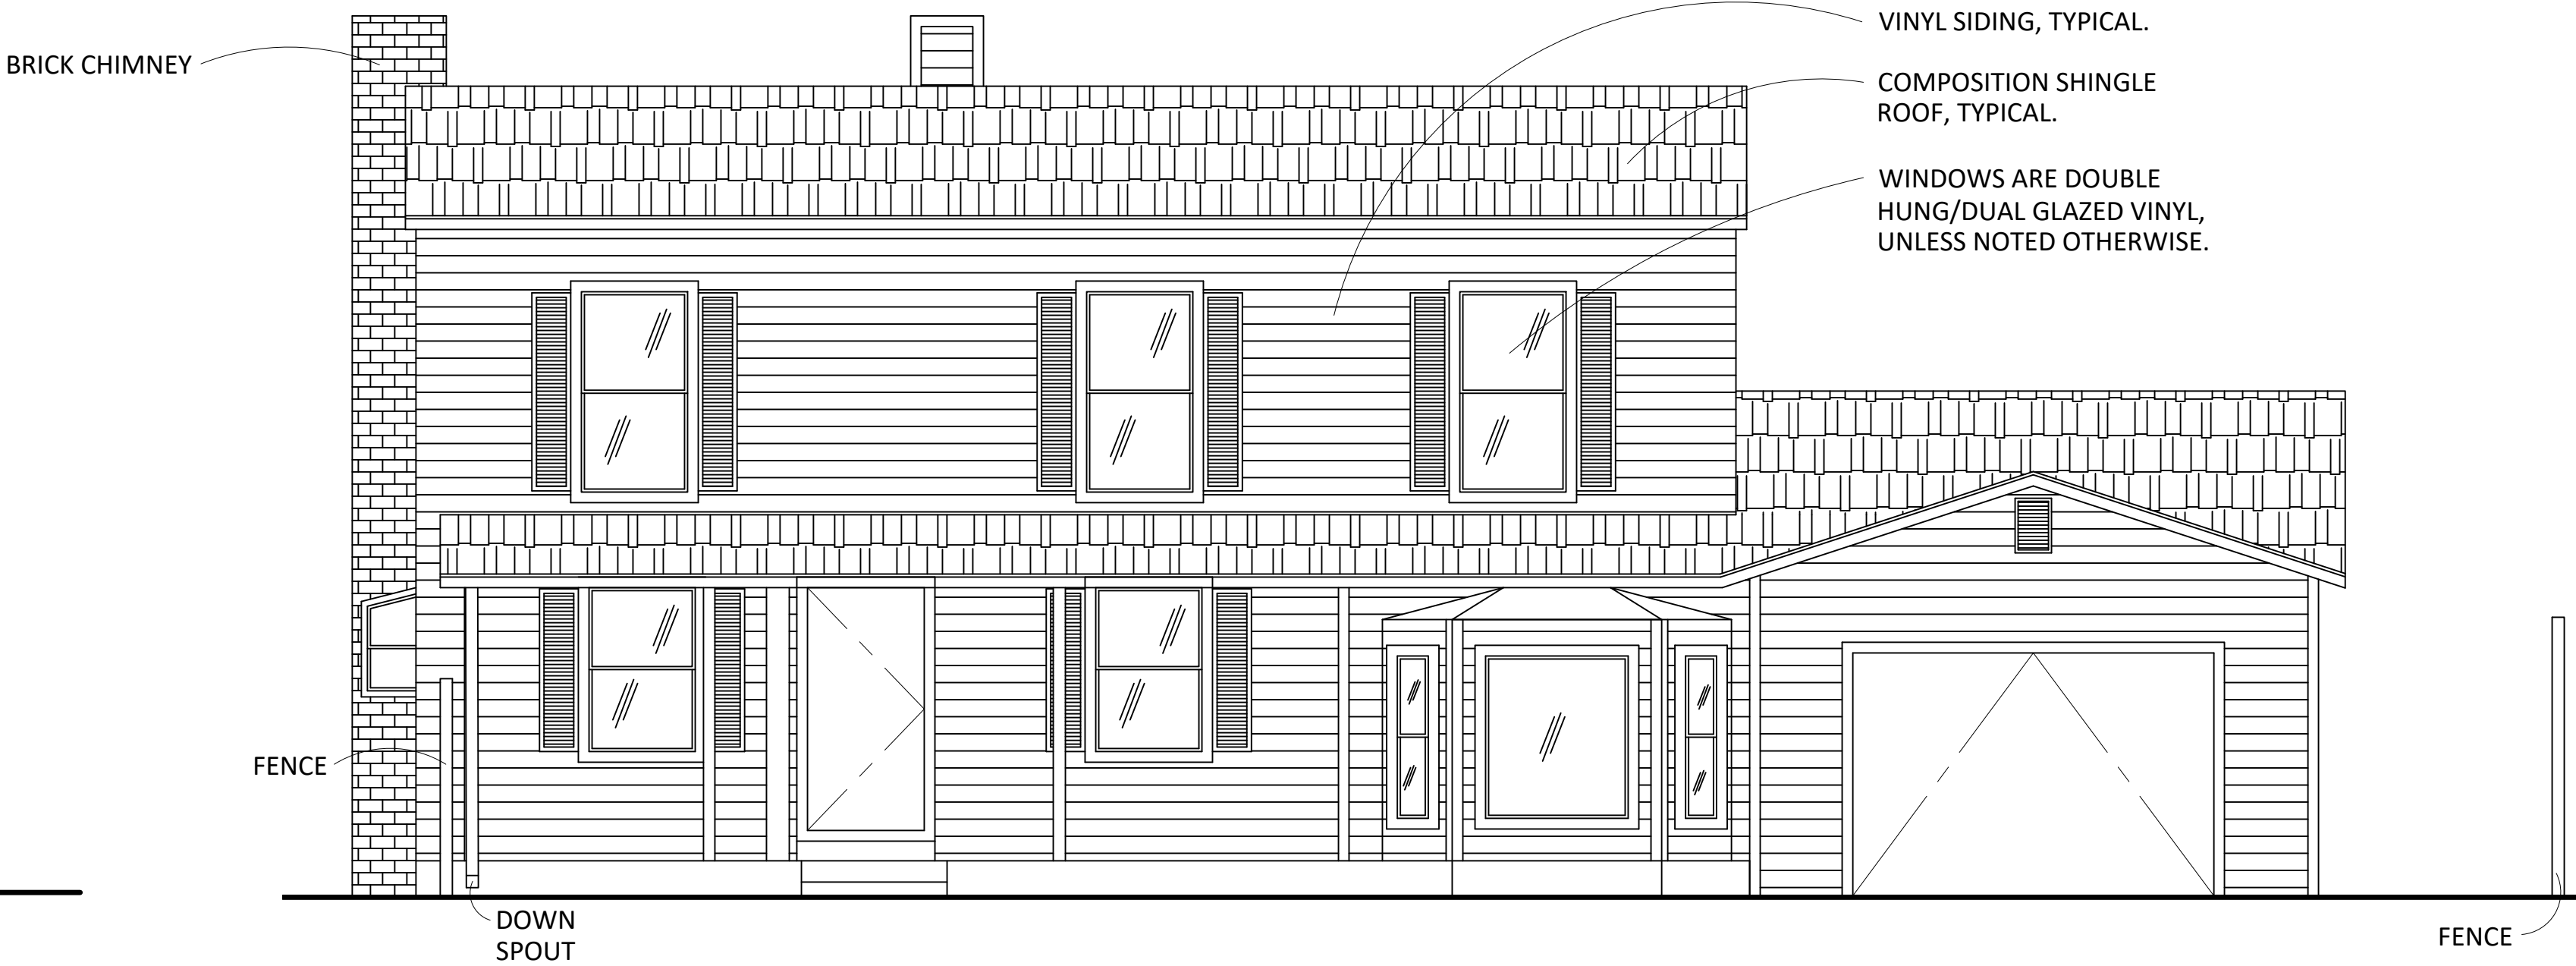

FRONT/ SOUTH ELEVATION

VINYL SIDING, TYPICAL.
COMPOSITION SHINGLE
ROOF, TYPICAL.
WINDOWS ARE DOUBLE
HUNG/DUAL GLAZED VINYL,
UNLESS NOTED OTHERWISE.

AS-BUILTS

SINGLE FAMILY RESIDENCE

2101 WEST AVENUE 136TH
SAN LEANDRO, CA 94577

REV/ DATE TITLE

7.16.18 AS-BUILTS

TITLE :

AS-BUILT
ELEVATIONS

SCALE : SCALE: 1/4" = 1'-0"
SHEET :

AB
0.3

AS-BUILT ELEVATIONS

2

SCALE: 1/4" = 1'-0"